


Labor and Materials

1	Copper	} Connection	3/4"	\$ 3.08
	Lead			
1	Curb	} T. S. & V.	3/4" in	\$ 3.89
	Cock			
	Valve			
1	Service Box	} Short 3 1/2 x 4 1/2		\$ 4.32
	Old returned			
	Long 4 1/2 x 5 1/2			
11	3/4 in.	} Pipe at	45	\$ 4.95
	Copper			
	Galv Iron			
	Cast Iron			
	Nipples	in. at		\$
	Bushings	to in. at		\$
	Red'g	} Conplings	to in. at	\$
	Inc'g			
	Union	in. at		\$
	Meter	in. at		\$
	Lead Joints at			\$
	Leadite Joints at			\$
	Hrs. Foreman at			\$
	Hrs. Chauffeur at			\$
	Hrs. Tapper at			\$
	Hrs. Labor at			\$
	Hrs. Labor at			\$
	Hrs. Compressor at			\$
	Compensation Ins.			\$
	Trucking			\$
	Builders Use of Water			\$
	Tap by Gifford			\$
	6-29-56			\$

St. *V 17*
 Pl. *Wilson*
 Ave. No. 13

Name of Owner
Wm. Garwood Jr

Labor and Mat'l. Report *June 29 1956*

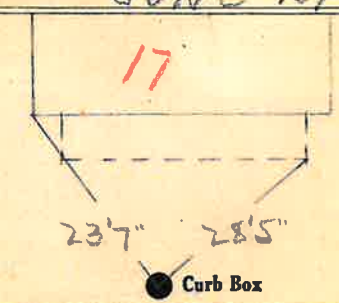

6" Main Elev. of Main at tap.....
 Gate at • Gate at

● Curb Box
 Renewal before Paving.
 TAX ID # 302.20-11-17
 6-28-22 Date of old Tap.