

Labor and Materials


1	Copper } Connection.....	3	\$ 2.60
	Lead }		
1	Curb } Cock }	2 1/2	\$ 2.30
	} Valve }		
	} T. S. & V. }		
1	Service Box } Short 3/4x1/4 }		\$ 1.40
	Old returned } Long 1/2x3/8 }		
	} Bull. or Rdway }		
6	Ft. in. } Copper } Pipe at.....	3	\$ 1.59
	} Galv. Iron }		
	} Cast Iron }		
	Nipples..... in. at.....		\$
	Bushings..... to..... in. at.....		\$
	Red'g } Couplings..... to..... in. at.....		\$
	Inc'g }		
	Union..... in. at.....		\$
	Meter..... in. at.....		\$
	Lbs. Br. Stone at.....		\$
	Lbs. Sand at.....		\$
	Bags Cement at.....		\$
	Paving Brick } Mack } at.....		\$
	} Red }		
	} Asphalt }		
	Lead Joints at.....		\$
	Leadite Joints at.....		\$
3	Hrs. Foreman at.....		\$ 1.89
5	Hrs. Common Labor at.....		\$ 2.03
	Hrs. Common Labor at.....		\$
	Hrs. Mason at.....		\$
	Hrs. Mason's Helper at.....		\$
	Hrs. Compressor at.....		\$
	Compensation Ins.....	10	\$
	Trucking.....		\$ 1.00
	Builders' Use of Water.....	Patch	\$ 5.00
Total \$.....			179.00

29-185

Labor and Material Report

January 22 1930

2 1/2 - 4 1/2 7/16 in. Pipe

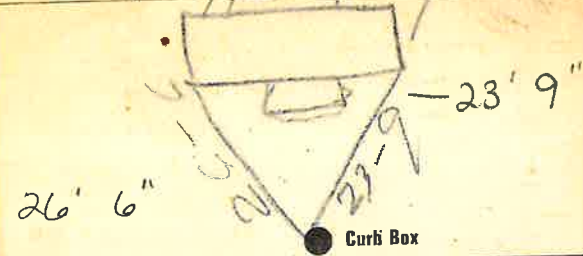

8 Main Elev of Main at tap 4 1/2

Gate at Gate at

Curb Box

Old top disconnected

2-4
TAX 10# 309.28-9-1