

Labor and Materials


4	Copper	Connection	3/4	\$ 2.60
1	Curb	Cock Valve	3/4 in.	\$ 2.30
1	Service Box	Short 3/4x4 1/2		\$ 1.40
	Old returned	Long 1 1/2x2 1/2		
9	Ft.	Copper Galv-iron Pipe at	3/4	\$ 2.39
	Nipples	in. at		\$
1	Bushings	3/4 to 1/2 in. at		\$.10
	Red'g Inc'g	Couplings	to in. at	\$
	Union	in. at		\$
	Meter	in. at		\$
	Lbs. Br. Stone	at		\$
	Lbs. Sand	at		\$
	Bags Cement	at		\$
	Paving Brick	Mack Red Asphalt at		\$
	Lead Joints	at		\$
	Leadite Joints	at		\$
3	Hrs.	Foreman at		\$ 1.98
8	Hrs.	Common Labor at		\$ 3.25
	Hrs.	Common Labor at		\$
	Hrs.	Mason at		\$
	Hrs.	Mason's Helper at		\$
	Hrs.	Compressor at		\$
	Compensation	Ins		\$.14
	Trucking			\$ 1.00
	Builders' Use of Water	Patch		\$ 5.00
Total				\$ 20.06

29-198

Labor and Material Report

11/9 1929

66 1/2 Main Buggy

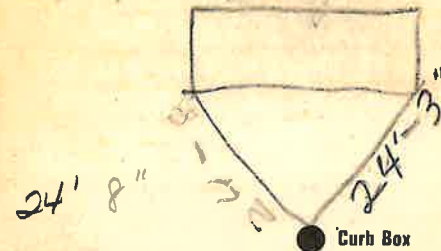

8 Main

Elev of Main at tap

Gate at

Gate at

Curb Box

Old top shut off

6-8

TAX 10th 309.28-9-2