

LABOR AND MATERIALS


1	Copper Lead	} Connection	3/4		\$ 1.35
1	Curb	Cock Valve T. S. & V.	3/4	in.	\$ 1.80
1	Service Box Old returned	{ Short 3 1/2 x 4 1/4 Long 4 1/2 x 5 1/4 Buffer Rdway }			\$ 1.70
12	Ft.	3/4 in.	{ Copper Galv-Iron Cast-Iron }	Pipe at 18	\$ 2.16
	Nipples	in. at			\$
	Bushings	to in. at			\$
	Red'g Inc'g	Couplings	to in. at		\$
	Union	in. at			\$
	Meter	in. at			\$
	Lead Joints at				\$
	Leadite Joints at				\$
	Hrs. Foreman at				\$
1	Hrs. Chauffeur at				\$ 63
5	Hrs. Tapper at				\$ 3.12
13	Hrs. Labor at				\$ 5.85
	Hrs. Labor at				\$
	Hrs. Compressor at				\$
	Compensation Ins.				\$.30
	Trucking				\$ 1-
	Builders Use of Water	Before Paving			\$
	<i>Taply Hessel</i>				\$
					\$
					\$
					\$ 17.91

7 0 1941

St.
Pt.
Ave. No. 10-12

New Pough
Name of Owner
Patrick Raflio

Labor and Mat'l. Report *June 11* 1941

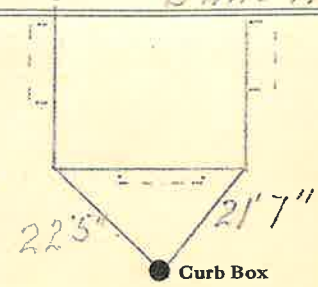

10 Main Elev. of Main at tap *5*
Gate at ● Gate at ●

● Curb Box
#10
Tax ID# 309.28-9-3

to be billed