

### Labor and Materials


1	Copper } Connection	3/4"	\$ 3.20
	Lead } Connection	3/4"	
1	Curb } Cock Valve T.S. & V. }	6" in.	\$ 1.00
1	Service Box } Short 3 1/2 x 4 1/2 }		\$ 1.30
	Old returned } Long 4 1/2 x 5 1/2 }		
		Buff. or Rdway }	
6	Ft. } in. } Copper Galv. Iron Cast Iron }	Pipe at	\$ 17.6
	Nipples	in. at	\$
1	Bushings	1/2" to 1/2" in. at	\$ .08
	Red'g } Couplings	to in. at	\$
	Inc'g }		
	Union	in. at	\$
	Meter	in. at	\$
	Lbs. Br. Stone	at	\$
	Lbs. Sand	at	\$
	Bags Cement	at	\$
	Paving Brick } Mack Red Asphalt }	at	\$
	Lead Joints	at	\$
	Leadite Joints	at	\$
1	Hrs. Foreman	at 62.5	\$ 63
5	Hrs. Common Labor	at 50	\$ 250
6	Hrs. Common Labor	at 40 7/8	\$ 244
	Hrs. Mason	at	\$
	Hrs. Mason's Helper	at	\$
	Hrs. Compressor	at	\$
	Compensation Ins.		\$ 16
	Trucking		\$ 1.00
	Builders' Use of Water		\$
Total			\$ 14.07

76-163

Labor and Material Report

19 26

Measurements for 16 new pipes

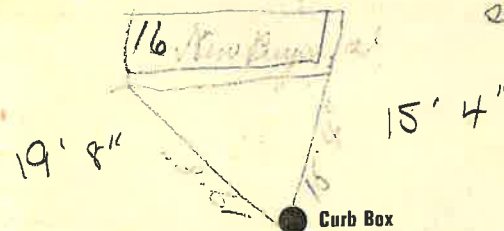

Main

Elev. of Main at tap 44 1/2

Gate at ●

● Gate at

● Curb Box