


LABOR AND MATERIALS

Copper	}	Connection		\$	
Lead					
Curb	}	Cock	} in.	\$	
		Valve			
		T. S. & V.			
Service box	}	Short 3½ x 4½	} _____	\$	
Old returned		Long 4½ x 5½			
26 Ft.	}	Copper	} Pipe at	\$	
3/4 in.		G.I.			
		G.I.			
Nipples		in. at		\$	
Bushings		to in. at		\$	
Red'g	}	Coupl'gs	to in. at	\$	
Inc'g					
Union		in. at		\$	
Meter		in. at		\$	
				\$	
Compound Joints		at		\$	
Maintenance Foreman				\$	
Hrs. Water Maint. Man-1		at		\$	
Hrs. Water Maint. Man-2		at		\$	
Hrs. Garage Foreman		at		\$	
Hrs. Labor		at		\$	
Hrs. Compressor		at		\$	
				\$	
Trucking				\$	
Pav't Patch				\$	
				\$	
				\$	
				\$	
				\$	

St. NEW
~~Pl.~~ Ave. No. 21

Name of Owner _____

Labor and Mat'l. Report 1997

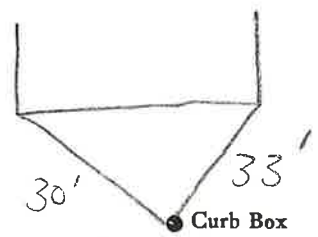

	Elev. of	
..... Main	Main at tap
Gate at ●		● Gate at

● Curb Box

Tax ID # 309.35-4-19