

LABOR AND MATERIALS


Copper	}	Connection	\$	
Lead				
Curb	}	Cock	\$	
		Valve	\$	
		T. S. & V.	\$	
Service box	}	Short 3½ x 4½		
Old returned		Long 4½ x 5½	\$	
31 Ft.	}	Copper	\$	
¾ in.		G. I.	\$	
		G. I.	\$	
Nipples		in. at	\$	
Bushings		to in. at	\$	
Red'g	}	Coupl'gs	\$	
Inc'g		to in. at	\$	
Union		in. at	\$	
Meter		in. at	\$	
			\$	
Compound Joints		at	\$	
Maintenance Foreman			\$	
Hrs. Water Maint. Man-1		at	\$	
Hrs. Water Maint. Man-2		at	\$	
Hrs. Garage Foreman		at	\$	
Hrs. Labor		at	\$	
Hrs. Compressor		at	\$	
			\$	
Trucking			\$	
Pav't Patch			\$	
			\$	
			\$	
			\$	
			\$	

New

St.
Pl.
Ave. No. 25

Name of Owner
Lyford

Labor and Mat'l. Report 1991

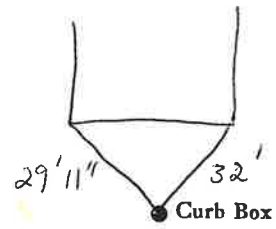

Main Elev. of Main at tap

Gate at ● ● Gate at

● Curb Box

Tax ID # 309.35-4-17