

Labor and Materials

Copper } Connection.....	3	\$ 1.33
Lead }	4	
Curb { Cock Valve m.s.w. }	2	\$ 1.58
Service Box { Short 3 1/2 x 4 1/2 }	4	\$ 1.36
Old returned { Long 1 1/2 x 5 1/2 }		
26 Ft. 3/4 in. { Copper Galv. Iron Cast Iron } Pipe at		\$ 2.47
Nipples		\$
Bushings		\$
Red'g } Couplings.....to.....in.at.....		\$
Inc'g }		\$
Union.....in. at		\$
Meter.....in. at		\$
Lbs. Br. Stone at		\$
Lbs. Sand at		\$
Bags Cement at		\$
Paving Brick { Mack Red Asphalt } at		\$
Lead Joints at		\$
Leadite Joints at		\$
5 Hrs. Foreman at		\$ 3.13
13 Hrs. Common Labor at		\$ 5.85
Hrs. Common Labor at		\$
Hrs. Mason at		\$
Hrs. Masons Helper at		\$
Hrs. Compressor at		\$
Compensation Ins		\$ 28
Trucking		\$ 1-
Builders Use of Water Patch		\$ 5-


Total \$ 72.00

33-20

Labor and Material Report

May 12 1933

27 New St

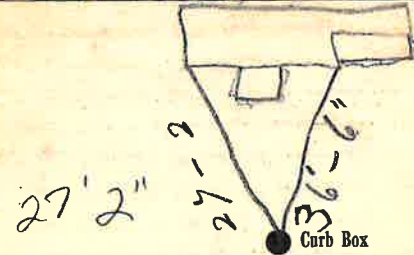

4 Main

Elev. of Main at tap 5

Gate at ●

● Gate at

● Curb Box

old Tap shut off

Tax ID # 309.7-14-16

74