

LABOR AND MATERIALS


1	Copper	{ Connection	3/4"	\$	3.04
1	Lead	{ Cock			
1	Curb	{ Valve	3/4 in.	\$	3.54
		{ T.S. & V.			
1	Service box	{ Short 3 1/2 x 4 1/2			
	Old returned	{ Long 4 1/2 x 5 1/2			
		{ Buff or Rdway		\$	4.70
25	Ft. 3/4 in.	{ Copper			
		{ G.I.	Pipe at 35	\$	8.75
		{ C.I.			
	Nipples	in. at		\$	
	Bushings	to in. at		\$	
	Red'g	{ Coupl'gs	to in. at	\$	
	Ine'g				
	Union	in. at		\$	
	Meter	in. at		\$	
	Lead Joints	at		\$	
	Compound Joints	at		\$	
2	Hrs. Water Maint. Man-1	at 1.23		\$	2.46
13	Hrs. Water Maint. Man-2	at 1.13		\$	14.69
21	Hrs. Labor	at 1.02		\$	21.42
	Hrs. Labor	at		\$	
2	Hrs. Compressor	at 1.50		\$	3.00
	Compensation Ins. at \$	per C.		\$	1.03
	Trucking			\$	1.00
	Pav't Patch			\$	10.80
	O'head			\$	
	Tap by Gifford			\$	74.43
	8-15-51				

135-1921

New St. Pl. 29 Ave. No.

Name of Owner Lapoint

Labor and Mat'l. Report August 15 1951

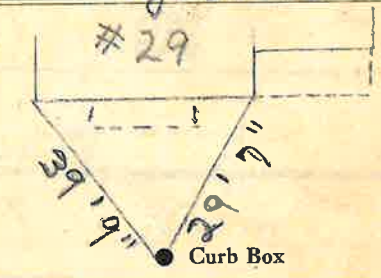

4" Main Elev. of Main at tap 5' Gate at Gate at

● Curb Box
Old tap disconnected
TAX ID # 309.7-14-15