


LABOR AND MATERIALS

1	Copper Lead	Connection	3/4"	\$	3.05
1	Curb	Cock Valve T.S. & V.	3/4 in.	\$	3.89
1	Service box	Short 3 1/2 x 4 1/2 Long 4 1/2 x 5 1/2 Buff or Rdway		\$	4.32
8	Ft. 3/4 in.	Copper C.I. C.I.	Pipe at 45'	\$	36.00
	Nipples	in. at		\$	
	Bushings	to in. at		\$	
	Red'g Inc'g	Coupl'gs to in. at		\$	
	Union	in. at		\$	
	Meter	in. at		\$	
	Lead Joints	at		\$	
	Compound Joints	at		\$	
	Maintenance Foreman			\$	
	Hrs. Water Maint. Man-1	at		\$	
	Hrs. Water Maint. Man-2	at		\$	
11	Hrs. Garage Foreman	at 2.053		\$	11.36
12	Hrs. Labor	at 1.30		\$	15.60
	Hrs. Compressor	at		\$	
	Compensation Ins.	at \$5.186 per C		\$	1.53
	Trucking			\$	1.50
	Pay't Patch			\$	10.80
	Tap by Harreau & Co			\$	
	7-9-56			\$	
	O'head			\$	
				\$	55.68

New St. Ave. No. 33

Name of Owner Doty

Labor and Mat'l. Report July 9 1956

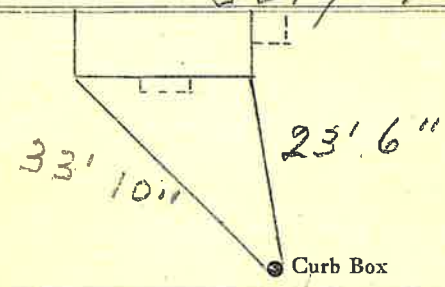

3" galv. Main Elev. of Main at tap 4'

Gate at • Gate at •

• Curb Box

Tax ID # 309.7-14-13