

LABOR AND MATERIALS

1	Copper Lead	Connection $\frac{1}{2} \times \frac{3}{4}$	\$ 1.23
1	Curb	Cock Valve T. S. & V. $\frac{3}{4}$ in.	\$ 1.68
1	Service Box Old returned	Short $3\frac{1}{2} \times 4\frac{1}{2}$ Long $4\frac{1}{2} \times 5\frac{1}{2}$ Buff. or Rdway	\$ 1.75
12	Ft. $\frac{3}{4}$ in.	Copper Galv Iron Cast Iron Pipe at	\$ 1.80
	Nipples	in. at	\$
	Bushings	to in. at	\$
	Red'g Inc'g	Couplings to in. at	\$
	Union	in. at	\$
	Meter	in. at	\$
	Lead Joints	at	\$
	Leadite Joints	at	\$
	Hrs. Foreman	at	\$
7	Hrs. Chauffeur	at .62 hr	\$ 1.25
5	Hrs. Tapper	at	\$ 3.13
5	Hrs. Labor	at .45	\$ 2.25
	Hrs. Labor	at	\$
	Hrs. Compressor	at	\$
	Compensation Ins.		\$ 21
	Trucking		\$ 1.00
	Builders Use of Water		\$ 5.00
	<i>Tap by 12.02.01</i>		\$
			\$
			\$
			\$
			\$
			\$ 19.30

1 4 4 - 1938

St.

Pl.


Ave. No. 37

Name of Owner

A Murray

Labor and Mat'l. Report

Nov 2 1938

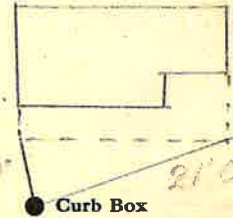

3 Main Gal.

Elev. of Main at tap 5-

Gate at ●

● Gate at

● Curb Box

Tax ID# 309.7-14-11

old shut off