


LABOR AND MATERIALS

1 Copper } Connection 1/2" \$  
~~1~~ Curb } Cock } 3/4" MARK II  
 Valve } ORISE #1  
 T.S. & V. }  
 1 Service box { Short 3 1/2 x 4 1/2 }  
 Old returned { Long 4 1/2 x 5 1/2 }  
 Buff or Rdway } \$  
 26 Ft. 3/4" in. { Copper } Pipe at \$  
 { ~~1/2"~~ }  
 Nipples in. at \$  
 Bushings to in. at \$  
 Red'g }  
 Inc'g } Coupl'gs to in. at \$  
 Union in. at \$  
 Meter in. at \$  
 1 Lead Joints at 90° E/Bowl 1/2" 3/4" \$  
 Compound Joints at \$  
 Maintenance Foreman \$  
 Hrs. Water Maint. Man-1 at \$  
 Hrs. Water Maint. Man-2 at \$  
 Hrs. Garage Foreman at \$  
 Hrs. Labor at \$  
 Hrs. Compressor at \$  
 Compensation Ins. at \$ per C \$  
 Trucking \$  
 Pav't Patch \$  
 Tap made By LARCAU Co \$  
 O'head April-21-1972 \$  
 \$

St. NEW  
 Ave. No. 3

Name of Owner EMMA CAPROOB

Labor and Mat'l. Report April 21 1972

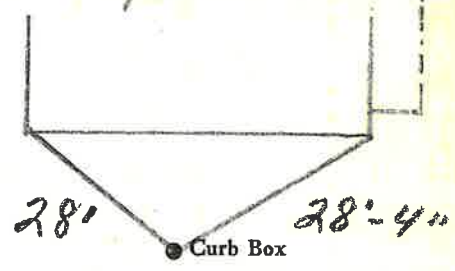

4" Main Elev. of Main at tap 4"  
 Gate at • Gate at

• Curb Box  
 Tax ID# 309.35-4-27