


**Labor and Materials**

1	Copper	Connection	3/4	\$3.20
1	Lead			
1	Curb	Cock Valve T.S. & V.	3/4 in.	\$1.00
1	Service Box	Short 3" x 4" Long 4" x 5" Buff. or Rdway		\$
27	Ft.	3/4 in.	Copper Galv. Iron Cast Iron	Pipe at \$594
	Nipples	in. at		\$
	Bushings	to in. at		\$
	Red'g Inc'g	Couplings	to in. at	\$
30	Union	1/2 in.	Galv. Pipe	\$570
	Meter	in. at		\$
	Lbs. Br. Stone	at		\$
	Lbs. Sand	at		\$
	Bags Cement	at		\$
	Paving Brick	Mack Red Asphalt	at	\$
	Lead Joints	at		\$
	Leadite Joints	at		\$
	Hrs. Foreman	at		\$
10	Hrs. Common Labor	at		\$4.05
	Hrs. Common Labor	at		\$
	Hrs. Mason	at		\$
	Hrs. Mason's Helper	at		\$
	Hrs. Compressor	at		\$
	Compensation Ins.			\$11
1	Trucking			\$1.00
No.	Builders' Use of Water			\$
Total				\$21.00

Labor and Material Report *Sept 30 1925*

*3/4 Top 15 No. 11 ST (106)*

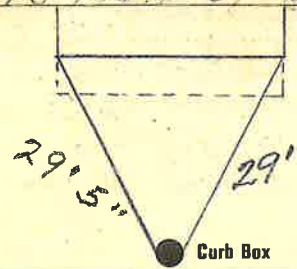

6 Main Elev. of Main at tap 5'

Gate at ● ● Gate at

● Curb Box

Tax ID # 309.35-4-22