


Labor and Materials

1	Copper } Connection.....	\$ 3.20
	Lead }	
1	Curb { Cock }	\$ 1.00
	{ Valve }	
	{ T. S. & V. }	
1	Service Box { Short 3" x 4" }	\$ 1.30
	Old returned { Long 4" x 5" }	
	{ Buff. or Rdway }	
26	Ft. 3/4" in. { Copper } Pipe at.....	\$ 5.72
	{ Galv. Iron }	
	{ Cast Iron }	
	Nipples..... in. at.....	\$
	Bushings..... to..... in. at.....	\$
1	Red'g } Couplings..... to..... in. at.....	\$ 1.0
	Inc'g }	
	Union..... in. at.....	\$
	Meter..... in. at.....	\$
	Lbs. Br. Stone at.....	\$
	Lbs. Sand at.....	\$
	Bags Cement at.....	\$
	Paving Brick { Mack } at.....	\$
	{ Red }	
	{ Asphalt }	
	Lead Joints at.....	\$
	Leadite Joints at.....	\$
	Hrs. Foreman at.....	\$
3	Hrs. Common Labor at.....	\$ 1.55
7	Hrs. Common Labor at.....	\$ 3.50
7	Hrs. Mason at.....	\$ 2.84
	Hrs. Mason's Helper at.....	\$
	Hrs. Compressor at.....	\$
	Compensation Ins.....	\$ 1.22
	Trucking.....	\$ 1.00
	Builders' Use of Water.....	\$
Total		\$ 20.76

Labor and Material Report

19 37

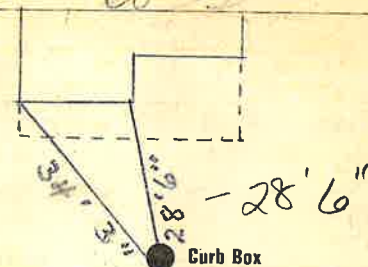

Main

Elev. of
Main at tap 5'

Gate at ●

● Gate at

● Curb Box

Old Tap to
be dug up
18' from side

Tax ID # 309.35-4-21