


LABOR AND MATERIALS

1 Copper } Connection 3/4" \$ _____
 1 Curb } Cock } 3/4 in. oriseal
 1 Service box } Short 3 1/2 x 4 1/2 } \$ _____
 Old returned } ~~Long 4 1/2 x 5 1/2~~
 } ~~Duff or Redway~~
25 Ft. 3/4 in. } Copper } Pipe at _____ \$ _____
 } ~~Curb~~
 } ~~Curb~~
 Nipples _____ in. at _____ \$ _____
 Bushings _____ to _____ in. at _____ \$ _____
 Red'g } Coupl'gs _____ to _____ in. at _____ \$ _____
 Inc'g }
 Union _____ in. at _____ \$ _____
 Meter _____ in. at _____ \$ _____
 Lead Joints at _____ \$ _____
 Compound Joints at _____ \$ _____
 Maintenance Foreman _____ \$ _____
 Hrs. Water Maint. Man—1 at _____ \$ _____
 Hrs. Water Maint. Man—2 at _____ \$ _____
 Hrs. Garage Foreman _____ at _____ \$ _____
 Hrs. Labor— _____ at _____ \$ _____
 Hrs. Compressor at _____ \$ _____
 Compensation Ins. at \$ _____ per C _____ \$ _____
 Trucking _____ \$ _____
 Pav't Patch _____ \$ _____
TAP BY FOSMEY & CO \$ _____
JUNE 28-1976 \$ _____
 O'head _____ \$ _____

St. 19
Ave. No. 19

New
 Name of Owner RYANIS TRISH
 Labor and Mat'l. Report JUNE 28 1976

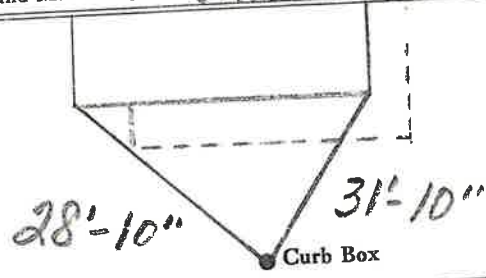

4" Main Elev. of Main at tap 4'
 Gate at • • Gate at

• Curb Box
 Tax ID # 309.35-4-20