

## LABOR AND MATERIALS

Copper Lead	Connection	Same	\$	—
1 Curb Valve T.S. & V.	3/4 in.	0 1/2 seal (add)	\$	—
1 Service Box Old returned	Short 3 1/2 x 4 1/2 Long 4 1/2 x 5 1/2 Buffer Rdway		\$	1.82
15 Ft. 3/4 in.	Copper Galv. Iron Cast Iron	12 ft Tubeloy Pipe at 18'	\$	2.70
Nipples	in. at		\$	
1 Bushings	1/2 to 3/4 in. at		\$	15
1 Red'g Inc'g Couplings	1/2 to 3/4 in. at	coupling to 1 1/2 in	\$	30
Union	in. at		\$	
Meter	in. at		\$	
Lead Joints at			\$	
Leadite Joints at			\$	
Hrs. Foreman at			\$	
13 Hrs. Chauffeur at	6.834		\$	8.94
Hrs. Tapper at			\$	
9 Hrs. Labor at	.60		\$	5.40
Hrs. Labor at			\$	
Hrs. Compressor at			\$	
Compensation Ins.	2.213		\$	32
Trucking			\$	1.00
Builders Use of Water			\$	18.33
Tap by Miller & Marsinski			\$	

This Tap changed over from Tubeloy to copper 1-7-64, \$38.96

20-43

St.

Pl.


North Delaware Ave. No. 4

Name of Owner

Adirondack Underwriters  
+ Realty Corp.

Labor and Mat'l. Report

July 30 1943

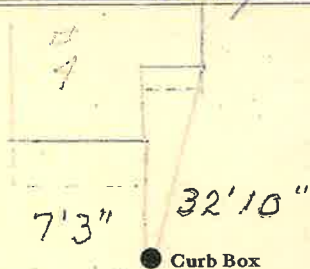

2

Main

Elev. of

Main at tap

5 1/2

Gate at ●

● Gate at

Tax ID# 309.27-6-9

● Curb Box

Replaced Tubeloy with  
3/4" K. Copper.  
1-7-64