

LABOR AND MATERIALS


Copper } Connection _____ \$ _____
 Lead }
 Curb } Cock _____ in. _____ \$ _____
 } Valve }
 } T.S. & V. }
 Service box { Short 3-1/2 x 4-1/2 } _____ \$ _____
 Old returned { Long 4-1/2 x 5-1/2 }
 Ft. _____ in. { Copper } Pipe at _____ \$ _____
 } G.I. }
 } C.I. }
 Nipples _____ in. at _____ \$ _____
 Bushings _____ to _____ in. at _____ \$ _____
 Red'g _____
 Inc'g _____
 Union _____ in. at _____ \$ _____
 Meter _____ in. at _____ \$ _____
 _____ \$ _____
 Compound Joints at _____ \$ _____
 Maintenance Foreman _____ \$ _____
 Hrs. Water Maint. Man - 1 at _____ \$ _____
 Hrs. Water Maint. Man - 2 at _____ \$ _____
 Hrs. Garage Foreman _____ at _____ \$ _____
 Hrs. Labor _____ at _____ \$ _____
 Hrs. Compressor at _____ \$ _____
 _____ \$ _____
 Trucking _____ \$ _____
 Pav't Patch _____ \$ _____
 _____ \$ _____
 _____ \$ _____
 _____ \$ _____

St. _____
 Pl. _____
 Ave. No. 6

Name of Owner Delaware

Labor and Mat'l. Report 10 4-14-05

HOUSE CURB BOX

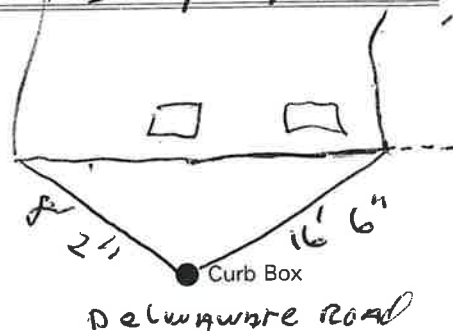


Delaware Road

Main _____ Elev. of Main at tap _____
 Gate at ● _____ Gate at _____

Tax ID # 309.27-68

CURB BOX FOR old 2" NY
 ● Curb Box

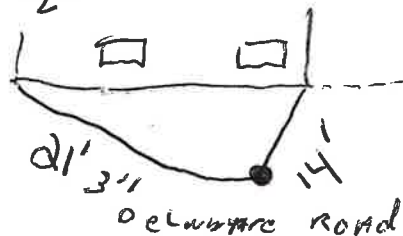

Delaware Road

Tony M + CONTRA

LABOR AND MATERIALS

Copper	} Connection -----	\$	
Lead			
2 Curb	} Cock Valve F. S. & V. {	3/4 in.	1.68 \$.36
1 Service Box Old returned			} Short 3 1/2 x 4 1/2 Long 4 1/2 x 5 1/2 Buff. or Rdway {
14 Ft. 3/4 in.	} Copper Galv Iron Gas Iron {	} Pipe at	
1 Nipples 3/4 in. at			3' hang. Brass
1 Bushings	3/4" to 3/4 in. at	Brass	\$.30
Red'g Inc'g	} Couplings to in. at		\$
1 Union 3/4 in. at		Brass	\$.12
Meter	in. at		\$
2" Lead Joints at	Brass St. El.		\$ 1.00
Leadite Joints at			\$
Hrs. Foreman at			\$
7 Hrs. Chauffeur at	6 1/2		\$ 4.37
7 Hrs. Tapper at			\$ 4.38
4 Hrs. Labor at			\$ 1.80
Hrs. Labor at			\$
Hrs. Compressor at			\$
Compensation Ins.			\$ 32
Trucking			\$ 1-
Builders Use of Water	no patch		\$
Trophy Milkix Hassel			\$
This top is an end of 2' main			\$
			\$
			\$ 20.69

97 -- 1939

St.

Pl

North Delaware

Ave. No. 6


Name of Owner

Geo P. ...

Labor and Mat'l. Report

Nov 15

1939

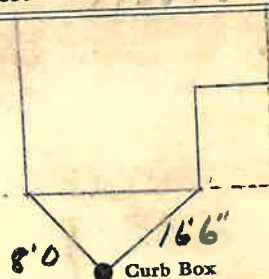

2' Gal Main

Elev. of Main at tap 5

Gate at ●

● Gate at

● Curb Box

J.B.

(To be charged)

old shut off