

LABOR AND MATERIALS

1	Copper	} Connection $\frac{1}{2}'' \times \frac{3}{4}''$	\$
	Lead		
1	Curb	} Cock Valve T.S. & V. } $\frac{3}{4}''$ in.	\$
1	Service box	} Short $3\frac{1}{2} \times 4\frac{1}{2}$ Long $4\frac{1}{2} \times 5\frac{1}{2}$ Buff or Rdway }	\$
	- Old returned		
8	Ft. $\frac{3}{4}''$ in.	} Copper G.I. G.I. }	Pipe at \$
	Nipples	in. at	\$
	Bushings	to in. at	\$
	Red'g	} Coupl'gs to in. at	\$
	Inc'g		
	Union	in. at	\$
	Meter	in. at	\$
	Lead Joints at		\$
	Compound Joints at		\$
	Maintenance Foreman		\$
	Hrs. Water Maint. Man-1 at		\$
	Hrs. Water Maint. Man-2 at		\$
	Hrs. Garage Foreman at		\$
	Hrs. Labor at		\$
	Hrs. Compressor at		\$
	Compensation Ins. at \$	per C	\$
	Trucking		\$
	Pav't Patch		\$
	Tap by GIFFORD		\$
	& Co. 8-15-61.		\$
	O'head		\$
			\$


North Pearl St. Ave. No. 35

Name of Owner

Murphy

Labor and Mat'l. Report

Aug. 15 1961

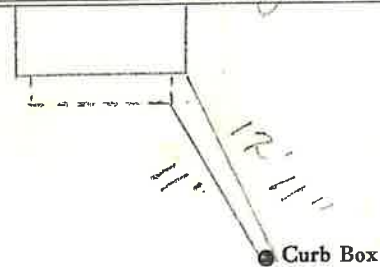

2" C.I. Main

Elev. of Main at tap 5'

Gate at •

• Gate at

• Curb Box

Tax 10th 303.17-1-42

Labor and Materials

1	Copper	} Connection	3/4"	\$ 96
1	Lead				
1	Curb	} Cock Valve T.S.&V.	3/4" in	\$ 1.33
1	Service Box Old returned				
		} Short 3 1/2 x 4 1/2 Long 4 1/2 x 5 1/2 Buff. or Rdway		\$ 1.35
10	Ft. 3/4 in.				
		} Copper Galv. Iron Cast Iron	Pipe at 15	\$ 1.50
	Nipples				
	Bushings to	in. at	\$
	Red'g Inc'g	} Couplings to	in. at	\$
	Union				
	Meter in. at	\$
	Lbs. Br. Stone	at	\$
	Lbs. Sand	at	\$
	Bags Cement	at	\$
	Paving Brick	} Mack Red Asphalt	at	\$
	Lead Joints				
	Leadite Joints	at	\$
	Hrs. Foreman	at	\$
	Hrs. Common Labor	at	\$
	Hrs. Mason	at	\$
	Hrs. Masons Helper	at	\$
	Hrs. Compressor	at	\$
	Compensation Ins	\$
	Trucking	\$
	Builders Use of Water	Patched	\$ 5.00
	Total \$			

94-36
 Labor and Material Report 9713 1936
 25 35
 North Pearl St. to ...
 Murphy
 Measurement
 take from
 20' measurement
 26
 28' 9"

 Curb Box
 12" Main Elev. of Main at tap 4
 Gate at • Gate at
 • Curb Box
 New Tap.
 AH
 Shut off at Curb
 New Tap 017
 North Pearl St.