


LABOR AND MATERIALS

1 Copper } Connection $\frac{1}{2} \times \frac{3}{4}$ " \$
 Lead }
 1 Curb } Cock } $\frac{3}{4}$ in. Oriseat. \$
 Valve }
 T. S. & V. }
 1 Service box { Short $3\frac{1}{2} \times 4\frac{1}{2}$ }
 Old returned { Long $4\frac{1}{2} \times 5\frac{1}{2}$ }
 { Buff or Rdway } \$
 12 Ft. $\frac{3}{4}$ in. { Copper } Pipe at \$
 { G.I. }
 { G.I. }
 Nipples in. at \$
 Bushings to in. at \$
 Red'g }
 Inc'g } Coupl'gs to in. at \$
 Union in. at \$
 Meter in. at \$
 Lead Joints at \$
 Compound Joints at \$
 Maintenance Foreman \$
 Hrs. Water Maint. Man-1 at \$
 Hrs. Water Maint. Man-2 at \$
 Hrs. Garage Foreman at \$
 Hrs. Labor at \$
 Hrs. Compressor at \$
 Compensation Ins. at \$ per C \$
 Trucking \$
 Pav't Patch \$
 Tap by Lareau + Co. \$
 9-10-69. \$
 O'head \$
 \$

North Pearl St. Ave. No. 36

Name of Owner
 Thomas Casey

Labor and Mat'l. Report Sept. 10 1969

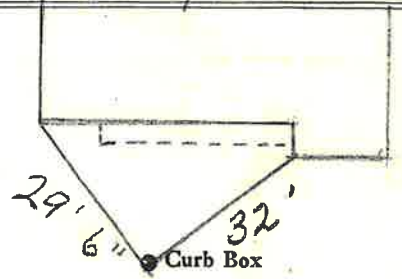

2" C.I. Main Elev. of Main at tap 4'

Gate at • • Gate at

• Curb Box

Tax ID# 303.17-1-39