

LABOR AND MATERIALS

| | | | | | |
|------------------------------|---|--------------------------------------|-------------------|--|----------|
| 1 Copper | Lead | Connection | $\frac{3}{4}$ | | \$ 1.23 |
| 1 Curb | { Cock Valve T. S. & V. } | | $\frac{3}{4}$ in. | | \$ 1.68 |
| 1 Service Box | { Short $3\frac{1}{2} \times 4\frac{1}{2}$ Long $4\frac{1}{2} \times 5\frac{1}{2}$ Buff. or Rdway } | | | | \$ 1.54 |
| Old returned | | | | | |
| 25 Ft. | $\frac{3}{4}$ in. | { Copper Galv Iron Cast Iron } | Pipe at 17 | | \$ 4.25 |
| Nipples | in. at | | | | \$ |
| Bushings | to in. at | | | | \$ |
| Red'g Inc'g | { Couplings | to in. at | | | \$ |
| Union | in. at | | | | \$ |
| Meter | in. at | | | | \$ |
| Lead Joints | at | | | | \$ |
| Leadite Joints | at | | | | \$ |
| Hrs. Foreman | at | | | | \$ |
| Hrs. Chauffeur | at | | | | \$ |
| Hrs. Tapper | at | | | | \$ |
| Hrs. Labor | at | | | | \$ |
| 4 Hrs. Labor | at | | 45 | | \$ 1.80 |
| Hrs. Compressor | at | | | | \$ |
| Compensation Ins. | | | | | \$.06 |
| Trucking | | | | | \$ 1- |
| Builders Use of Water | | | | | \$ |
| <i>Tap by Honsal</i> | | | | | |
| <i>Patch (1/2 Sump Pump)</i> | | | | | |
| | | | | | \$ 2.50 |
| | | | | | \$ |
| | | | | | \$ 14.06 |

6 4 - - 1939

St.

Pl.


North Road Ave. No. *6*

Name of Owner

Ligman

Labor and Mat'l. Report

Aug 31 19*32*

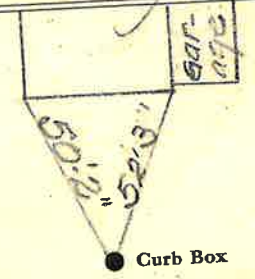

4 Main Elev. of Main at tap *4 1/2*

Gate at ● Gate at ●

● Curb Box

Lot #6

New House