

LABOR AND MATERIALS


Copper	}	Connection		\$		
Lead						
Curb	}	Cock	} in.	\$		
		Valve				
		T. S. & V.				
Service box	}	Short 3½ x 4½	} _____	\$		
Old returned		Long 4½ x 5½				
		Buff or Rdway				
25 Ft. ^{3/4}	}	Copper	} Pipe at	\$		
		G. I.				
		C. I.				
Nipples	in.	at		\$		
Bushings	to	in.	at	\$		
Red'g	}	Coupl'gs	to	in.	at	\$
Inc'g						
Union	in.	at		\$		
Meter	in.	at		\$		
Lead Joints	at			\$		
Compound Joints	at			\$		
Maintenance Foreman				\$		
Hrs. Water Maint. Man—1	at			\$		
Hrs. Water Maint. Man—2	at			\$		
Hrs. Garage Foreman	at			\$		
Hrs. Labor—	at			\$		
Hrs. Compressor	at			\$		
Compensation Ins.	at \$	per C		\$		
Trucking				\$		
Pav't Patch				\$		
				\$		
				\$		
O'head				\$		
				\$		

St. _____
Pl. _____
Ave. No. 8

North Road
Name of Owner _____

Tax ID # 302.11-3-2
remeasured

Labor and Mat'l. Report 9-1-1982

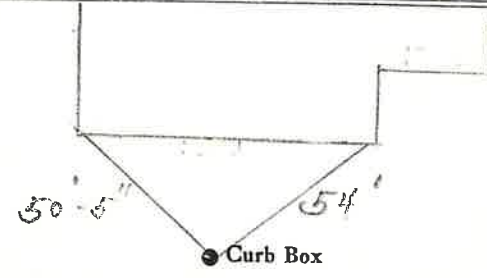

Main Elev. of
Main at tap

Gate at ● ● Gate at

● Curb Box