

### LABOR AND MATERIALS

Copper Lead	Connection	3/4	\$ 1.23
Curb	Cock Valve T. S. & V.	3/4 in.	\$ 1.68
			\$ 1.54
Service Box Old returned	Short 3 1/2 x 4 1/2 Long 4 1/2 x 5 1/2 Buff. or Rdway		\$ 1.54
9 Ft. 3/4 in.	Copper Galv. Iron Cast Iron	Pipe at 17	\$ 1.53
Nipples	in. at		\$
Bushings	to in. at		\$
Red'g Inc'g	Couplings	to in. at	\$
Union	in. at		\$
Meter	in. at		\$
Lead Joints	at		\$
Leadite Joints	at		\$
Hrs. Foreman	at		\$
Hrs. Chauffeur	at		\$
Hrs. Tapper	at		\$
4 Hrs. Labor	at 45		\$ 1.80
Hrs. Labor	at		\$
Hrs. Compressor	at		\$
Compensation Ins.			\$ .06
Trucking			\$ 1.00
Builders Use of Water			\$
Tap by Hessel			\$
Patch (Up Sewer Dept)			\$ 9.50
			\$
			\$ 11.34

\$ 3 - - 1939

St. ?

Pl. 9

Ave. No. 9


Name of Owner

Edmonds

Labor and Mat'l. Report

Aug 31

1939

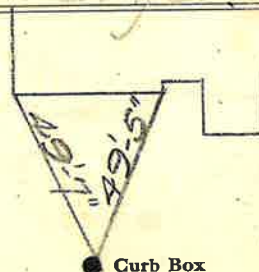

Main

Elev. of

Main at tap 42

Gate at ●

● Gate at

TAX ID # 302.11-4-9

● Curb Box

Lot # 20

M

New House