

LABOR AND MATERIALS

1	Copper Lead	} Connection	$\frac{3}{4}$		\$ 1.31
1	Curb	{ Cock Valve T. S. & V.	$\frac{3}{4}$	in.	\$ 1.75
1	Service Box Old returned	{ Short $3\frac{1}{2} \times 4\frac{1}{2}$ Long $4\frac{1}{2} \times 5\frac{1}{2}$ Buffer Rdway			\$ 1.60
12	Ft.	{ Copper Galv Iron Cast Iron	$\frac{3}{4}$	in. } Pipe at	18 \$ 2.16
	Nipples			in. at	\$
	Bushings			to in. at	\$
	Red'g Inc'g	{ Couplings		to in. at	\$
	Union			in. at	\$
	Meter			in. at	\$
	Lead Joints at				\$
	Leadite Joints at				\$
	Hrs. Foreman at				\$
2	Hrs. Chauffeur at		$6\frac{1}{2}$		\$ 1.25
4	Hrs. Tapper at		-		\$ 2.50
5	Hrs. Labor at		45		\$ 3.60
	Hrs. Labor at				\$
	Hrs. Compressor at				\$
	Compensation Ins.				\$.23
	Trucking				\$ 1.00
	Builders Use of Water	$\frac{1}{2}$ Patch (Summer)			\$ 2.50
	Tape by Hessel				\$
					\$
					\$
					\$
					\$
					\$ 17.90

148 - 1940

St. 11
Pl. Ave. No. 8


North Road

Name of Owner

Berndt

Labor and Mat'l. Report

Nov 13 1940

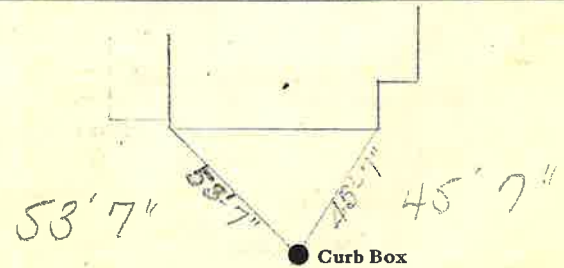

7 Main

Elev. of
Main at top 5

Gate at ●

● Gate at

● Curb Box

Box ID# 302.11-4-8