


LABOR AND MATERIALS

Copper	} Connection		\$			
Lead						
Curb	} Cock Valve T. S. & V.	} in.	\$			
				Service box	} Short 3 1/2 x 4 1/2	\$
		Buff or Rdway	\$			
Ft.	} in.	} Copper	\$			
				} G. I.	} Pipe at	\$
Nipples	in.	at	\$			
Bushings	to	in.	at	\$		
Red'g	} Coupl'gs	to	in.	at	\$	
Inc'g						
Union	in.	at	\$			
Meter	in.	at	\$			
Lead Joints	at	\$				
Compound Joints	at	\$				
Maintenance Foreman		\$				
Hrs. Water Maint. Man	1 at	\$				
Hrs. Water Maint. Man	2 at	\$				
Hrs. Garage Foreman	at	\$				
Hrs. Labor	at	\$				
Hrs. Compressor	at	\$				
Compensation Ins.	at \$	per C	\$			
Trucking		\$				
Pav't Patch		\$				
		\$				
		\$				
O'head		\$				
		\$				

North Road St. 14  
Pl.  
Ave. No. 14  
 Name of Owner \_\_\_\_\_

Measured in  
 Labor and Mat'l. Report MAY 5 1975

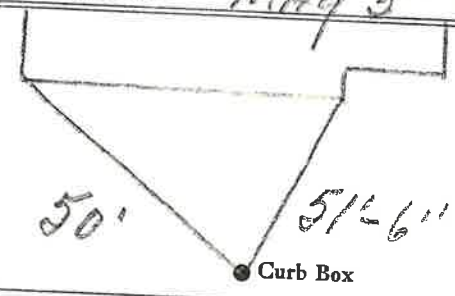

Main Elev. of Main at tap  
 Gate at • • Gate at

• Curb Box

TAX ID # 302.11-3-4