


Labor and Materials

1	Lead Connection	2	\$
1	Curb Cock		\$
1	Service Box (Short 3' x 4')		\$
	Old returned (Long 4' x 6')		\$
1.1	1/2 in. G. Pipe at		\$
	Nipples in. at		\$
	Bushings to in. at		\$
3/4	Red'g Coup. to in. at		\$
	Inc'g Coup. to in. at		\$
	Union in. at		\$
	Meter in. at		\$
	Cu. Yds. Br. Stone at		\$
	Cu. Yds. Sand at		\$
	Bags Cement at		\$
	Paving Brick { Mack Red Asphalt } at		\$
1 1/2	Hrs. Foreman at		\$
3	Hrs. Common Labor at		\$
	Hrs. Mason at		\$
4	Hrs. <i>Comptroller</i> at		\$
	Hrs. at		\$
100	Builders' Use of Water		\$
	at		\$
1	Truck		\$
	at		\$
	at		\$
	at		\$
	at		\$
	Total	1449	\$

Labor and Material Report

lot 24 195

no 2C note

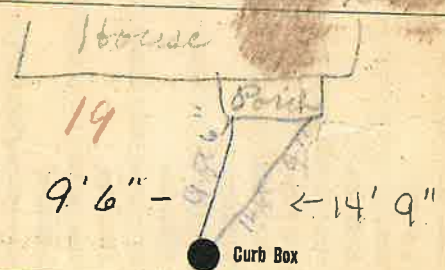

6" Main

Elev. of Main at tap 5.50

Gate at ●

● Gate at

● Curb Box

Tax ID # 302, 20-16-6

John Miller