


Labor and Materials

Lead Connection.....	\$
1 Curb Cock.....	\$
1 Service Box { Short 3' x 4' / Old returned Long 4' x 6' / Buffalo }	\$
1.1 Ft. 3 in. G.I. Pipe at.....	\$
Nipples..... in. at.....	\$
Bushings..... to..... in. at.....	\$
Red'g Coup..... to..... in. at.....	\$
Inc'g Coup..... to..... in. at.....	\$
Union..... in. at.....	\$
Meter..... in. at.....	\$
Cu. Yds. Br. Stone at.....	\$
Cu. Yds. Sand at.....	\$
Bags Cement at.....	\$
Paving Brick { Mack / Red / Asphalt } at.....	\$
1.4 Hrs. Foreman at.....	\$
1.3 Hrs. Common Labor at.....	\$
Hrs. Mason at.....	\$
Hrs. at.....	\$
4 Hrs. Equip. at.....	\$
2.0 Builders' Use of Water.....	\$
Truck 100.....	\$
Paint.....	\$
Total.....	\$

93 Labor and Material Report

19

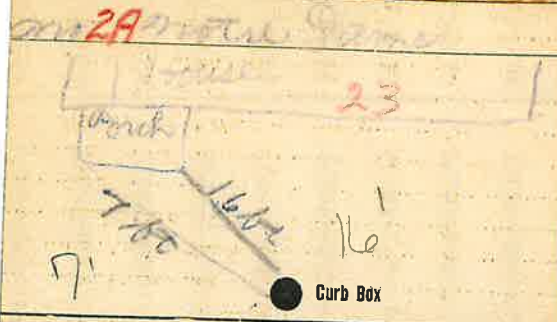

6" Main Elev. of Main at tap 5.75  
 Gate at ● Gate at ●  
 Curb Box

REVERSE BOX  
 TAX ID# 302.20-16-4