

LABOR AND MATERIALS

1	Copper Lead	Connection	3/4"		\$
1	Curb	Cock Valve T.S. & V.	3/4 in.	Omiseal	\$
1	Service box	Short 3 1/2 x 4 1/2			\$
	Old returned	Long 4 1/2 x 5 1/2			\$
		Built or Rdway			\$
31	Ft.	3/4 in.	Copper G.I. G.I.	Pipe at	\$
	Nipples	in.		at	\$
	Bushings	to	in.	at	\$
	Red'g Inc'g	Coupl'gs	to	in.	at \$
	Union	in.		at	\$
	Meter	in.		at	\$
	Lead Joints	at			\$
	Compound Joints	at			\$
	Maintenance Foreman				\$
	Hrs. Water Maint. Man	1 at			\$
	Hrs. Water Maint. Man	2 at			\$
	Hrs. Garage Foreman	at			\$
	Hrs. Labor	at			\$
	Hrs. Compressor	at			\$
	Compensation Ins.	at \$	per C		\$
	Trucking				\$
	Pav't Patch				\$
	Tap by Gifford & Co.				
	10-6-67.				
	O'head				\$


St. W. Notre Dame
Pl. 11
Ave. No. 11

Name of Owner

First Presbyterian Church

Labor and Mat'l. Report

Oct. 6, 1967.

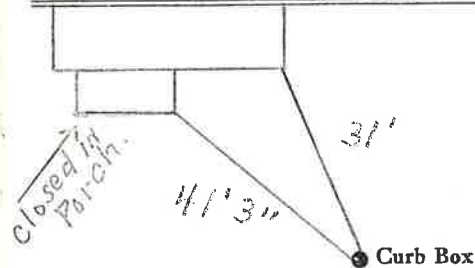

6" Main

Elev. of Main at tap 5 1/2'

Gate at ●

● Gate at

Tax ID # 302.20-7-24

● Curb Box