

LABOR AND MATERIALS

1	Copper	} Connection	3/4	\$ 1.23
	Lead			
1	Curb	} Cock Valve T. S. & V.	3/4 in.	\$ 1.68
1	Service Box	} Short 3 1/2 x 4 1/2 Long 4 1/2 x 5 1/2 Buff. or Rdway		\$ 1.75
	Old returned			
9	Ft. 3/4 in.	} Copper Galv. Iron Cast Iron	Pipe at 1/5	\$ 1.35
	Nipples	in. at		\$
	Bushings	to	in. at	\$
	Red'g Inc'g	} Couplings	to	in. at
	Union	in. at		\$
	Meter	in. at		\$
	Lead Joints	at		\$
	Leadite Joints	at		\$
	Hrs. Foreman	at		\$
6	Hrs. Chauffeur	at	6 2 1/2	\$ 3.75
	Hrs. Tapper	at		\$
9	Hrs. Labor	at	.45	\$ 4.05
	Hrs. Labor	at		\$
2	Hrs. Compressor	at	8 7 1/2	\$ 1.75
	Compensation Ins.			\$ 24
	Trucking			\$ 100
	Builders Use of Water			\$ 900
	Tap by Power			\$
				\$
				\$
				\$ 25.90

138-1938

St. 14W

Pl:

Ave. No. 20


Nate Davis

Name of Owner

Kiley

Labor and Mat'l. Report

Sept 30 1930

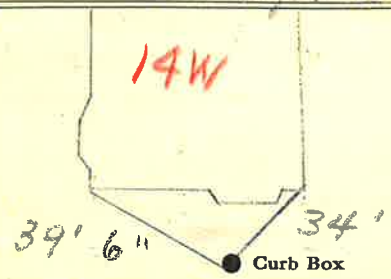

6 Main

Elev. of
Main at tap 5

Gate at ●

● Gate at

TOWK ID # 302.20-15-5

● Curb Box

old shut off