

15 W
 Labor and Material Report 004 21 1945

TAP AT 21 NOTRE DAME ST.

HOUSE
 15 W
 FENCE
 porex
 14' 1/4"
 9' 6"
 Curb Box

6" Main Elev. of Main at tap 5'


Gate at ● Gate at ●

● Curb Box

NOTRE DAME St. 15 W.
 Pt. Ave. No.

Name of Owner
 MEASURED ON 2/12/2008 By T.M.

Labor and Mat'l. Report 19

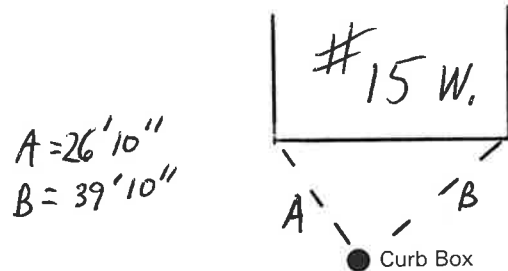

A = 26' 10"
 B = 39' 10"

6" Main Elev. of Main at tap 5'

Gate at ● Gate at ●

● Curb Box

Tax ID # 302.20-7-23

Labor and Materials

1. Lead Connection *at* \$
 1. Curb Cock *at* \$
 1. Service Box (Short 3 1/2 x 4 1/2) *at* \$
 Old returned *Long 4 1/2 x 6 1/2* Buffalo *at* \$
 23 Ft. 2 in. G.I. Pipe at \$
 Nipples in. at \$
 1. Bushings 1/2 to 1/2 in. at \$
 1. Red'g Coup. 1/2 to 1/2 in. at *at* \$
 Inc'g Coup. to in. at \$
 Union in. at \$
 Meter in. at \$
 Cu. Yds. Br. Stone at \$
 Cu. Yds. Sand at \$
 Bags Cement at \$
 Paving Brick { Mack Red Asphalt } at \$
 Hrs. Foreman at \$
 19 Hrs. Common Labor at \$
 Hrs. Mason at \$
 Hrs. at \$
 Hrs. at \$
 4.5 Builders' Use of Water \$
 Trucking at \$
 at \$
 at \$
 at \$
 Total \$

LABOR AND MATERIALS

Copper } Connection \$
 Lead }
 Curb } Cock } in. \$
 Valve } T.S. & V. }
 Service box { Short 3-1/2 x 4-1/2 } \$
 Old returned { Long 4-1/2 x 5-1/2 }
 23 Ft. 3/4 in. { Copper } Pipe at \$
 { G.I. }
 { C.I. }
 Nipples in. at \$
 Bushings to in. at \$
 Red'g
 Inc'g
 Union in. at \$
 Meter in. at \$
 \$
 Compound Joints at \$
 Maintenance Foreman \$
 Hrs. Water Maint. Man - 1 at \$
 Hrs. Water Maint. Man - 2 at \$
 Hrs. Garage Foreman at \$
 Hrs. Labor at \$
 Hrs. Compressor at \$
 \$
 Trucking \$
 Pav't Patch \$
 \$
 \$
