


Labor and Materials

1.....Lead Connection.....	\$	
.....Curb Cock.....	\$	
.....Service Box { Short 8' x 4' / Old returned { Long 4' x 5' / Buffalo	\$	
23 Ft. 1" in. G. I. Pipe at.....	\$	
.....Nipples.....in. at.....	\$	
.....Bushings.....to.....in. at.....	\$	
.....Red'g Coup...to...in. at.....	\$	
.....Inc'g Coup...to...in. at.....	\$	
.....Union...in. at.....	\$	
.....Meter...in. at.....	\$	
.....Cu. Yds. Br. Stone at.....	\$	
.....Cu. Yds. Sand at.....	\$	
.....Bags Cement at.....	\$	
.....Paving Brick { Mack / Red / Asphalt } at.....	\$	
7 Hrs. Foreman at.....	\$	
6 Hrs. Common Labor at.....	\$	
.....Hrs. Mason at.....	\$	
.....Hrs.....at.....	\$	
.....Hrs.....at.....	\$	
8.0 Builders' Use of Water.....	\$	
.....at.....	\$	
.....at.....	\$	
.....at.....	\$	
.....at.....	\$	
Total	\$	17.46

17W Labor and Material Report Apr 23 1924

3/4 tap at 2.8 Meter Dam at

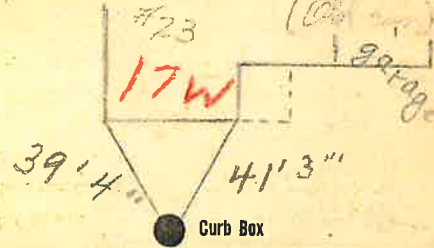

Main Elev. of Main at tap 5/4

Gate at ● TAX ID # 302.20-7-22 ● Gate at

● Curb Box