

Labor and Materials

1	Copper } Connection	3/4	\$	3.20
	Lead }			
1	Curb } Cock Valve } T.S. & V. }	3/4 in.	\$	1.00
1	Service Box } Short 3 1/2 x 4 1/2 } Old returned } Long 4 1/2 x 5 1/2 } Ruff. or Rdway }		\$	1.30
24	Ft. 1 in. } Copper } Galv. Iron } Cast Iron }	Pipe at	\$	5.28
	Nipples	in. at	\$	
	Bushings	to in. at	\$	
1	Red'dg } Couplings	1/2 in. at	\$	1.50
	Union	in. at	\$	
	Meter	in. at	\$	
	Lbs. Br. Stone	at	\$	
	Lbs. Sand	at	\$	
	Bags Cement	at	\$	
	Paving Brick } Mack } Red } Asphalt }	at	\$	
	Lead Joints	at	\$	
	Leadite Joints	at	\$	
5	Hrs. Foreman	at	\$	8.13
4	Hrs. Common Labor	at	\$	2.00
8	Hrs. Common Labor	at	\$	3.25
	Hrs. Mason	at	\$	
	Hrs. Mason's Helper	at	\$	
2	Hrs. Compressor	at	\$	4.00
	Compensation Ins.		\$	46
	Trucking		\$	1.00
	Builders' Use of Water		\$	


Pavement to follow
 Total \$ 29.77

Labor and Material Report

Aug 9

1927

3/4 tap at 25 Notre Dame st

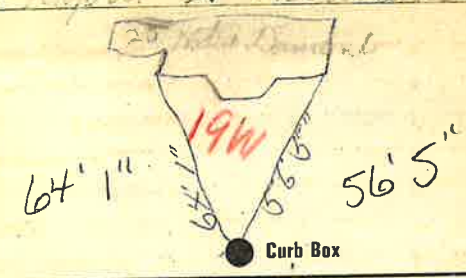

6" Main
 Elev. of Main at tap 12 ft
 Gate at ● Gate at ●

● Curb Box

Old tap shut off
 1" RENEWAL TAP - 1999
 Tax ID # 302.20-7-21