


Labor and Materials

1	Copper } Connection ^{3/4}	\$ 3.20
	Lead	
1	Curb } Cock Valve } ^{3/4} in	\$ 1.00
	T.S. & V.	
1	Service Box } Short 3 1/2 x 4 1/2	\$ 1.30
	Old returned } Long 4 1/2 x 5 1/2	
		Buff. or Rdway
16	Ft. ^{3/4} in. } Copper } Pipe at	\$ 33.0
		Galv. Iron
		Cast Iron
	Nipples.....in. at	\$
	Bushings.....to.....in. at	\$
	Red'g } Couplings.....to.....in. at	\$
	Inc'g }	
	Union.....in. at	\$
	Meter.....in. at	\$
	Lbs. Br. Stone at	\$
	Lbs. Sand at	\$
	Bags Cement at	\$
	Paving Brick } Mack } at	\$
		Red
		Asphalt
	Lead Joints at	\$
	Leadite Joints at	\$
7	Hrs. Foreman at	\$ 43.8
	Hrs. Common Labor at	\$ 7.22
19	Hrs. Common Labor at ^{10 1/2}	\$
	Hrs. Mason at	\$
	Hrs. Mason's Helper at	\$
1	Hrs. Compressor at	\$ 1.170
	Compensation Ins.	\$ 32
	Trucking	\$ 10.0
	Builders' Use of Water	\$
Total		\$ 23.72

27-229 29W
 Labor and Material Report Dec 1 1927

#35 North Dame St

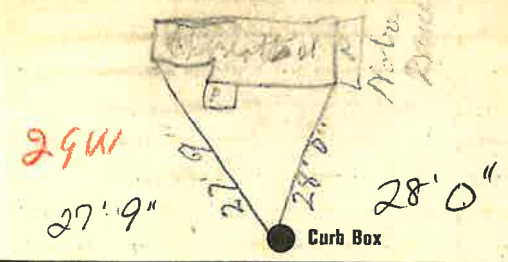

Main Elev. of Main at tap 4.2

Gate at ● Gate at ●

● Curb Box

Old shut off
 TAX ID # 302.20-7-18