

LABOR AND MATERIALS

1	Copper Lead	Connection	3/4	\$	1.35
1	Curb	Cock Valve T.S. & V.	3/4 in.	\$	1.80
1	Service Box Old returned	Short 3 1/2 x 4 1/2 Long 4 1/2 x 5 1/2 Buffer Rdway		\$	1.70
10	Ft.	3/4 in.	Copper Galv Iron Cast Iron Pipe at 18	\$	1.80
	Nipples	in. at		\$	
	Bushings	to in. at		\$	
	Red'g Inc'g	Couplings	to in. at	\$	
	Union	in. at		\$	
	Meter	in. at		\$	
	Lead Joints at			\$	
	Leadite Joints at			\$	
	Hrs. Foreman at			\$	
5	Hrs. Chauffeur at	6 2/2		\$	3.13
	Hrs. Tapper at			\$	
6	Hrs. Labor at	45		\$	2.70
	Hrs. Labor at			\$	
	Hrs. Compressor at			\$	
	Compensation Ins.			\$	18
	Trucking			\$	1-
	Builders Use of Water	Patch 3		\$	9.-
				\$	
				\$	
				\$	22.65



13.66

247 1041

St. 34W
Pl. 38
Ave. No. 38


West
Natra Drive

Name of Owner

Mrs. K. Linneman

Labor and Mat'l. Report

Oct 30 1941

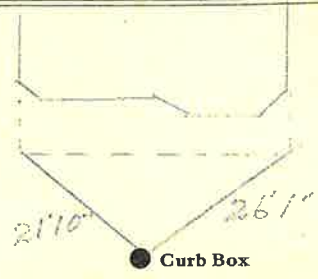

4 Main

Elev. of Main at tap 5

Gate at ●

● Gate at

● Curb Box

TOUC ID # 302.20-14-10

To be billed \$1100

H.