

LABOR AND MATERIALS

/	Copper Lead	} Connection	3/4		\$ 270
/	Curb	{ Clock Valve T.S. & V. }	3/4 in.		\$ 3.60
/	Service box Old returned	{ Short 3 1/2 X 4 1/2 Long 4 1/2 X 5 1/2 Buffer Rdway }			\$ 5.80
36	Ft. 3/4 in.	{ Copper Galv. Iron Cast Iron }	Pipe at	3512.60	\$ 3512.60
	Nipples	in. at			\$
	Bushings	to in. at			\$
	Red'g Inc'g	{ Couplings to in. at			\$
	Union	in. at			\$
	Meter	in. at			\$
	Lead Joints at				\$
	Compound Joints at				\$
6	Hrs. Foreman at				\$ 4.95
1	Hrs. Chauffeur at	82 1/2			\$ 83
12	Hrs. Tapper at	82 1/2			\$ 858
	Hrs. Labor at	71 1/2			\$
	Hrs. Labor at				\$
	Hrs. Compressor at				\$
	Compensation Ins.				\$ 32
	Trucking				\$ 8.00
	Builders Use of Water				\$
	<i>Tap by Warrington</i>				\$
					\$
					\$
					\$ 48.48


22-47

St.
~~Pl.~~
Ave. No. 37

West Natick Drive

Name of Owner
Trousdale

Labor and Mat'l. Report *May 9* 19*47*

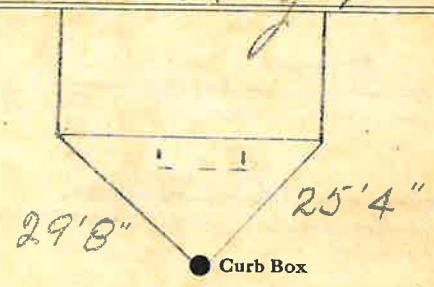

4 Main Elev. of Main at tap 6

Gate at ● ● Gate at

● Curb Box

TAX ID# 302.20-3-22