

### LABOR AND MATERIALS


1	Copper	{ Connection	3/4		\$ 2.29
	Lead				
1	Curb	{ Cock Valve	3/4	in.	\$ 2.70
		F. S. & V.			
1	Service box	{ Short 3 1/2 x 4 1/2			
	Old returned	Long 4 1/2 x 5 1/2			
		Buff or Rdway			\$ 4.25
10	Ft. 3/4 in.	{ Copper			
		G. I.	35	Pipe at	\$ 3.50
		C. I.			
	Nipples	in. at			\$
	Bushings	to in. at			\$
	Red'g Inc'g	{ Coupl'gs to in. at			\$
	Union	in. at			\$
	Meter	in. at			\$
	Lead Joints	at			\$
	Compound Joints	at			\$
5	Hrs. Water Maint. Man	1 at			\$
102	Hrs. Water Maint. Man	2 at			\$ 5.10
14	Hrs. Labor	at	91		\$ 12.74
	Hrs. Labor	at			\$
	Hrs. Compressor	at			\$
	Compensation Ins.	at \$ per C.			\$ 40
	Trucking				\$ 1.00
	Pav't Patch				\$ 11.20
	Tap by <i>Megawick</i>				\$
	O'head				\$
					\$ 43.18

32-1950

St. \_\_\_\_\_  
 Pt. \_\_\_\_\_  
 Ave. No. 40

Name of Owner  
Numman

Labor and Mat'l. Report May 8 1950

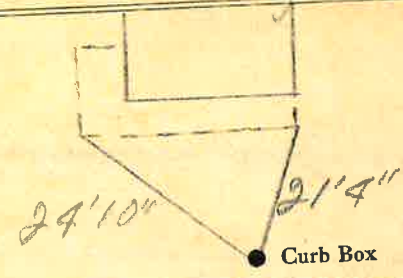

● Curb Box

---

4 Main Elev. of Main at tap 5

Gate at ● ● Gate at

● Curb Box

Tax ID# 302.20-14-13