

#55

Labor and Materials

1	Copper } Connection	3/4"	\$ 1.48
	Lead		
1	Curb } Cock Valve	3/4" in.	\$ 1.79
	T-S & V.		
1	Service Box } Short 3/4"		\$ 1.46
	Old returned } Long 1 1/2 x 5/8"		
		Buff. or Redway	
19	Ft. 3/4" in. } Copper Galv. Iron } Pipe at		\$ 3.42
		Cast Iron	
	Nipples	in. at	\$
	Bushings	to in. at	\$
	Red'g } Couplings	to in. at	\$
	Inc'g }		
	Union	in. at	\$
	Meter	in. at	\$
	Lbs. Br. Stone	at	\$
	Lbs. Sand	at	\$
	Bags Cement	at	\$
	Paving Brick } Mack Red Asphalt	at	\$
	Lead Joints	at	\$
	Leadite Joints	at	\$
31	Hrs. Foreman		\$ 19.38
	Hrs. Common Labor		\$
	Hrs. Common Labor		\$
	Hrs. Mason		\$
	Hrs. Mason's Helper		\$
3	Hrs. Compressor	8 1/2 hr	\$ 2.63
	Compensation Ins		\$.59
	Trucking		\$ 1.00
	Builders' Use of Water	Patch	\$ 9.00
Total \$			40.75


32-55 10E

Labor and Material Report

May 28

1932

3/4 tap at 9 Metre Demand

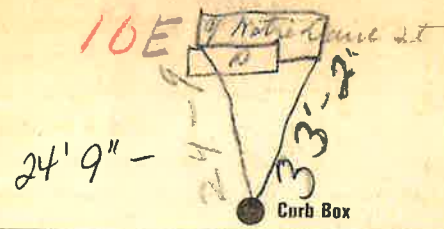

6" Main Elev of Main at tap 5.60

Gate at ● ● Gate at

Old tap shut off

Tax ID# 302.20-12-17

OK LTD.