

Labor and Materials


1	Copper } Connection $\frac{3}{4}$	\$ 3.20
	Lead }	
1	Curb } Cock Valve } $\frac{3}{4}$ in.	\$ 1.00
	T. S. & V. }	
	Service Box } Short $3\frac{1}{2} \times 4\frac{1}{2}$	
	Old returned } Long $4\frac{1}{2} \times 5\frac{1}{2}$	
		Buff. or Rdway
25	Ft. in. } Copper } Pipe at.	\$ 5.50
		Galv. Iron
		Cast Iron
	Nipples in. at.	\$
	Bushings to in. at.	\$
	Red'g } Couplings to in. at.	\$
	Inc'g }	
	Union in. at.	\$
	Meter in. at.	\$
	Lbs. Br. Stone at.	\$
	Lbs. Sand at.	\$
	Bags Cement at.	\$
	Paving Brick } Mack } at.	\$
		Red
		Asphalt
	Lead Joints at.	\$
	Leadite Joints at.	\$
4	Hrs. Foreman at.	\$ 2.50
1.1	Hrs. Common Labor at.	\$ 4.47
	Hrs. Common Labor at.	\$
	Hrs. Mason at.	\$
	Hrs. Mason's Helper at.	\$
	Hrs. Compressor at.	\$
	Compensation Ins.	\$.18
1	Trucking	\$ 1.00
2.0	Builders' Use of Water.....	\$
	<i>Payment</i>	Total \$ 17.85

Labor and Material Report

Oct 31

1925

47 Notre Dame St

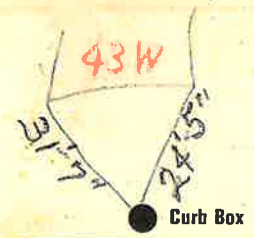

6 Main

Elev. of Main at tap *5*

Gate at ●

● Gate at

● Curb Box

Tax ID # 302.20-3-20