

LABOR AND MATERIALS

} Copper	} Connection.....			\$
} Lead				
} Curb	} Cock Valve	}	} in.	} \$
} T. S. & V.				
} Service Box	} Short 3"x4"	}	}	} \$
} Old returned	} Long 4"x5"	}	}	} \$
} Buff or Rdway				
} 7 Ft.	} Copper	} Pipe at	}	} \$
} 3/4 in.	} Galv Iron			
}	} Cast Iron			
} Nipples.....	} in. at	}	}	} \$
} Bushings	} to	} in. at	}	} \$
} Red'g	} Couplings	} to	} in. at	} \$
} Inc'g				
} Union	} in. at	}	}	} \$
} Meter	} in. at	}	}	} \$
} Lead Joints at	}	}	}	} \$
} Leadite Joints at	}	}	}	} \$
} Hrs. Foreman at	}	}	}	} \$
} Hrs. Chauffeur at	}	}	}	} \$
} Hrs. Tapper at	}	}	}	} \$
} Hrs. Labor at	}	}	}	} \$
} Hrs. Labor at	}	}	}	} \$
} Hrs. Compressor at	}	}	}	} \$
} Compensation Ins.	}	}	}	} \$
} Trucking	}	}	}	} \$
} Builders Use of Water	}	}	}	} \$
}	}	}	}	} \$
}	}	}	}	} \$
}	}	}	}	} \$
}	}	}	}	} \$


St. 53W
Pt. _____
Ave. No. 57

Notre Dame

Name of Owner _____

AUG 25 1939

Labor and Mat'l. Report _____ 19

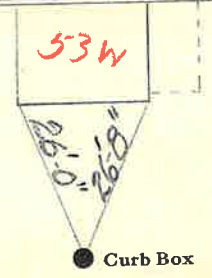

● Curb Box

Main Elev. of Main at tap.....

Gate at ● ● Gate at

● Curb Box

Tax ID# 302.19-25-26


LABOR AND MATERIALS

Copper	} Connection	_____	\$ _____	
Lead				
Curb	} Cock Valve } T. S. & V. }	_____ in.	\$ _____	
1 Service box		} Short 3 1/2 x 4 1/2 } Long 4 1/2 x 5 1/2 } Buff or Rdway }	_____ ?	\$ _____
Old returned				
Ft. _____ in.	} Copper } C. I. } C. I. }	Pipe at _____	\$ _____	
Nipples _____ in.		at _____	\$ _____	
Bushings _____ to _____ in.		at _____	\$ _____	
Red'g } Inc'g }	} Coupl'gs	_____ to _____ in.	\$ _____	
Union _____ in.		at _____	\$ _____	
Meter _____ in.	at _____	\$ _____		
Lead Joints	at _____	\$ _____		
Compound Joints	at _____	\$ _____		
Maintenance Foreman	_____	\$ _____		
Hrs. Water Maint. Man-1	at _____	\$ _____		
Hrs. Water Maint. Man-2	at _____	\$ _____		
Hrs. Garage Foreman	at _____	\$ _____		
Hrs. Labor	at _____	\$ _____		
Hrs. Compressor	at _____	\$ _____		
Compensation Ins. at \$ _____ per C	_____	\$ _____		
Trucking	_____	\$ _____		
Pav't Patch	_____	\$ _____		
O'head	_____	\$ _____		
		\$ _____		

St. _____
Pl. _____
Ave. No. 53

Name of Owner _____

Drawn in _____
Labor and Mat'l. Report Aug 30 19 71

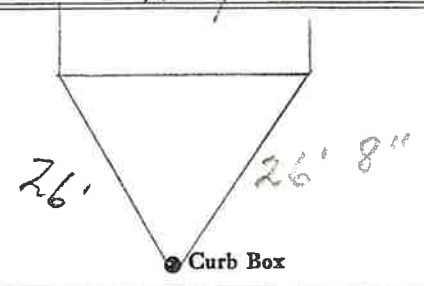

6 Main Elev. of Main at tap 5-5 1/2
Gate at • Gate at •

• Curb Box