


### LABOR AND MATERIALS

Copper	} Connection	_____	\$ _____	
Lead				
Curb	} Cock Valve } T. S. & V. }	_____ in.	\$ _____	
		} Short 3½ x 4½ } Long 4½ x 5½ }		
Service box			\$ _____	
Old returned			\$ _____	
Ft. <u>34</u> in.	} Copper G.I. C.I. }	Pipe at _____	\$ _____	
Nipples	_____ in. at _____		\$ _____	
Bushings	_____ to _____ in. at _____		\$ _____	
Red'g	} Coupl'gs	_____ to _____ in. at _____	\$ _____	
Inc'g				
Union	_____ in. at _____		\$ _____	
Meter	_____ in. at _____		\$ _____	
			\$ _____	
Compound Joints	at _____		\$ _____	
Maintenance Foreman			\$ _____	
Hrs. Water Maint. Man—1	at _____		\$ _____	
Hrs. Water Maint. Man—2	at _____		\$ _____	
Hrs. Garage Foreman	at _____		\$ _____	
Hrs. Labor	at _____		\$ _____	
Hrs. Compressor	at _____		\$ _____	
			\$ _____	
Trucking			\$ _____	
Pav't Patch			\$ _____	
			\$ _____	
			\$ _____	
			\$ _____	
			\$ _____	

St. W. Notre Dame  
~~Pl.~~  
 Ave. No. 54

Name of Owner \_\_\_\_\_  
 Tax ID# 302.19-28-5

Labor and Mat'l. Report 1988

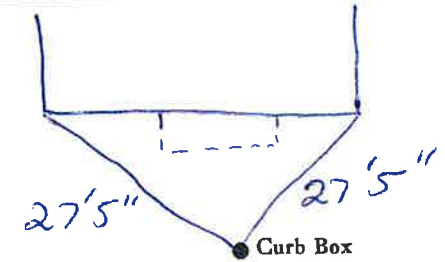

	Elev. of
_____ Main	Main at tap _____
Gate at ●	● Gate at
_____	
_____	
	● Curb Box