


LABOR AND MATERIALS

Copper	} Connection	_____	\$ _____
Lead			
Curb	} Cock Valve T. S. & V.	} _____ in.	\$ _____
Service box	} Short 3 1/2 x 4 1/2 Long 4 1/2 x 5 1/2	}	\$ _____
Old returned			
19 1/2 Ft.	} Copper C.I. C.I.	} Pipe at _____ in.	\$ _____
3/4			
Nipples	_____ in.	at _____	\$ _____
Bushings	_____ to _____	in. at _____	\$ _____
Red'g Inc'g	} Coupl'gs.	} to _____ in.	at _____ \$ _____
Union			
Meter	_____ in.	at _____	\$ _____
Compound Joints	at _____		\$ _____
Maintenance Foreman	_____		\$ _____
Hrs. Water Maint. Man—1	at _____		\$ _____
Hrs. Water Maint. Man—2	at _____		\$ _____
Hrs. Garage Foreman	_____ at _____		\$ _____
Hrs. Labor—	_____ at _____		\$ _____
Hrs. Compressor	at _____		\$ _____
Trucking	_____		\$ _____
Pav't Patch	_____		\$ _____
			\$ _____
			\$ _____
			\$ _____
			\$ _____

St. Notre Dame  
~~Pl.~~  
 Ave. No. 56W

Name of Owner \_\_\_\_\_  
TAX ID # 302.19-28-60

Labor and Mat'l. Report 19

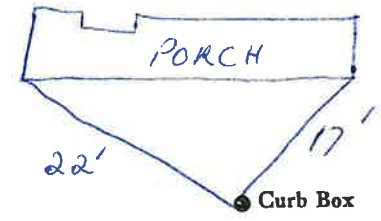

	Elev. of
Main	Main at tap _____
Gate at ●	● Gate at _____

● Curb Box