

LABOR AND MATERIALS


Copper	} Connection	_____	\$ _____		
Lead		_____	\$ _____		
Curb	} Cock	} in. _____	\$ _____		
				} Valve	} T.S. & V.
Service box Old returned	{	Short 3½ x 4½	_____		
		Long 4½ x 5½	_____		
		Buff or Rdway	_____		
17' Ft. 0" in.	{	Copper	} Pipe at _____		
		G. I.			
		C. I.			
Nipples	in. at _____	\$ _____			
Bushings	to _____ in. at _____	\$ _____			
Red'g	} Coupl'gs. _____ to _____ in. at _____	\$ _____			
Inc'g		\$ _____			
Union	in. at _____	\$ _____			
Meter	in. at _____	\$ _____			
Lead Joints	at _____	\$ _____			
Compound Joints	at _____	\$ _____			
Maintenance Foreman	_____	\$ _____			
Hrs. Water Maint. Man-1	at _____	\$ _____			
Hrs. Water Maint. Man-2	at _____	\$ _____			
Hrs. Garage Foreman	at _____	\$ _____			
Hrs. Labor	at _____	\$ _____			
Hrs. Compressor	at _____	\$ _____			
Compensation Ins. at \$ _____	per C _____	\$ _____			
Trucking	_____	\$ _____			
Pav't Patch	_____	\$ _____			
	_____	\$ _____			
	_____	\$ _____			
May 4, 1980, by	_____	\$ _____			
B. [Signature]	_____	\$ _____			
O'head	_____	\$ _____			
	_____	\$ _____			

Notre Dame

St. PT. Ave. No. ^{West} 57

Name of Owner _____

Labor and Mat'l. Report May 4 1980

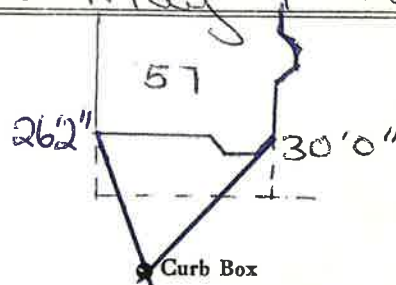

6" Main

Elev. of Main at tap 5'

Gate at ●

● Gate at

● Curb Box