


LABOR AND MATERIALS

1	Copper	} Connection	3/4"	\$
1	Curb		} 3/4 in. (MAYN II) (ORISEMI)	\$
1	Service box	} { Short 3 1/2 x 4 1/2 Long 4 1/2 x 5 1/2 Buff. or Rdway		} 4' x 5'
22	Ft. 3/4 in.		} { Copper Gal.	
	Nipples	in. at		\$
	Bushings	to in. at	\$	
	Red'g	} Coupl'gs	to in. at	\$
	Inc'g			
	Union	in. at	\$	
	Meter	in. at	\$	
	Lead Joints at	\$		
	Compound Joints at	\$		
	Maintenance Foreman	\$		
	Hrs. Water Maint. Man-1 at	\$		
	Hrs. Water Maint. Man-2 at	\$		
	Hrs. Garage Foreman at	\$		
	Hrs. Labor at	\$		
	Hrs. Compressor at	\$		
	Compensation Ins. at \$	per C	\$	
	Trucking	\$		
	Pav't Patch	\$		
	TAP MADE BY St John & Co			
	MAY-23-1973			
	O'head	\$		
	\$			

St. West Notre Dame Ave. No. 58

Name of Owner LATHAISE

Labor and Mat'l. Report MAY 23 1973

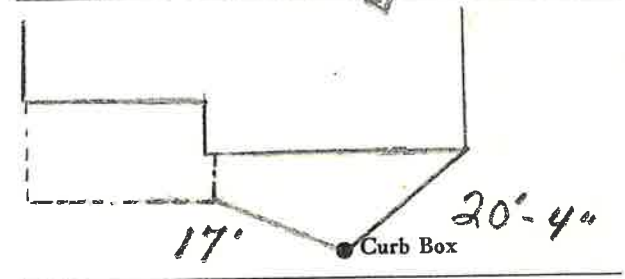

6" Main Elev. of Main at tap 5'

Gate at • • Gate at

• Curb Box

Tax ID# 302.19-28-7