


LABOR AND MATERIALS

1	Copper	} Connection	3/4"	\$	
Lead					
1	Curb	} Cock Valve T.S.&V.	3/4 in.	MAYKIL DY (SBAI) \$	
1	Service box	} Short 3 1/2 x 4 1/2		\$	
Old returned					Long 4 1/2 x 5 1/2
					Buff or Rdway
16	Ft.	} Copper	3/4 in.	Pipe at \$	
					Gal.
	Nipples	in. at		\$	
	Bushings	to in. at		\$	
	Red'g	} Coupl'gs	to in. at	\$	
	Inc'g				
	Union	in. at		\$	
	Meter	in. at		\$	
	Lead Joints	at		\$	
	Compound Joints	at		\$	
	Maintenance Foreman			\$	
	Hrs. Water Maint. Man-1	at		\$	
	Hrs. Water Maint. Man-2	at		\$	
	Hrs. Garage Foreman	at		\$	
	Hrs. Labor	at		\$	
	Hrs. Compressor	at		\$	
	Compensation Ins.	at \$ per C		\$	
	Trucking			\$	
	Pav't Patch			\$	
	TAP MADE BY ST JOHN YC				
	AUG-12-1974				
	O'head			\$	
				\$	

St. PR
W. Notre Dame Ave. No. 59

Name of Owner
LAWRENCE WINCHELL

Labor and Mat'l. Report AUG-12 1974

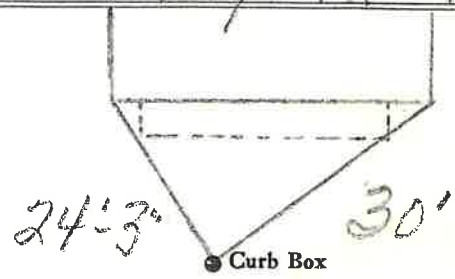

6" Main Elev. of Main at tap 4'
 Gate at • Gate at •

• Curb Box
 TAX ID# 302.19-25-23