


LABOR AND MATERIALS

1	Copper Lead Connection	<u>3/4"</u>				\$ 2.76
1	Curb	Cock Valve	}	3/4 in.		\$ 3.49
		T. S. & V.				
1	Service box	Short 3 1/2 X 4 1/2	}			\$ 4.74
	Old returned	Long 4 1/2 X 5 1/2				
		Buff or Rdway				
13	Ft. <u>3/4</u> in.	Copper	}		Pipe at 38	\$ 4.94
		G. I.				
		C. I.				
	Nipples in. at				\$
	Bushings to			in. at	\$
	Red'g				\$
	Inc'g	Coupl'gs to			\$
	Union in. at				\$
	Meter in. at				\$
	Lead Joints	at				\$
	Compound Joints	at				\$
2	Hrs. Water Maint. Man-1	at	1.52			\$ 3.04
12	Hrs. Water Maint. Man-2	at	1.24			\$ 14.88
25	Hrs. Labor at	1.13			\$ 28.25
	Hrs. Labor at				\$
	Hrs. Compressor	at				\$
	Compensation Ins.	at \$4.06 per C				\$ 2.03
	Trucking				\$ 1.00
	Pav't Patch				\$ 13.44
	Tap by Gissard	12-11-52				\$
	O'head				\$
						\$ 78.57

8-53
St. ~~Pl~~
W. Notre Dame Ave. No. 63

Name of Owner
Louis M. Carusone

Labor and Mat'l. Report Dec. 11 1952

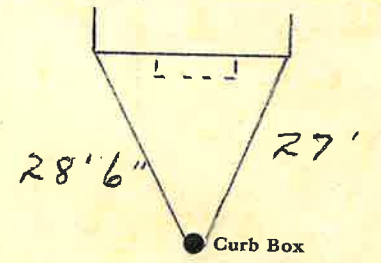

6" Main Elev. of Main at tap 5 1/2'
Gate at ● Gate at ●

● Curb Box

Tax ID # 302.19-25-21