


LABOR AND MATERIALS

1	Copper	} Connection	3/4"	\$		
1	Lead					
1	Curb	} Valve	3/4 in.	\$		
		} T.S. & V. } 3/4 in. or 1 seal				
1	Service box	} Short 3 1/2 x 4 1/2		\$		
	Old returned		} Long 4 1/2 x 5 1/2			
				} Buff or Rdway		
22	22 Ft. 3/4 in.	} Copper	} Pipe at		\$	
				} C.I.		
						} C.I.
	Nipples	in. at	\$			
	Bushings	to in. at	\$			
	Red'g } Inc'g	} Coupl'gs	to in. at	\$		
	Union	in. at	\$			
	Meter	in. at	\$			
	Lead Joints at		\$			
	Compound Joints at		\$			
	Maintenance Foreman		\$			
	Hrs. Water Maint. Man-1 at		\$			
	Hrs. Water Maint. Man-2 at		\$			
	Hrs. Garage Foreman at		\$			
	Hrs. Labor— at		\$			
	Hrs. Compressor at		\$			
	Compensation Ins. at \$	per C	\$			
	Trucking		\$			
	Pav't Patch		\$			
	Tap by Gifford & Co.		\$			
	7-24-63.		\$			
	O'head		\$			
			\$			

St. W. Notre Dame
 Pl. 64
 Ave. No. 64

Name of Owner
Robert Phelps.

Labor and Mat'l. Report July 24 1963

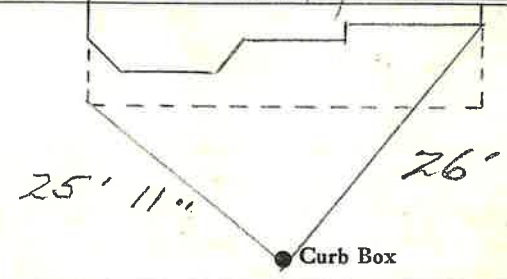

6" C.I. Main
 Elev. of Main at tap 5 1/2'
 Gate at ● Gate at ●

● Curb Box
 Tax ID # 302.19-28-10