

LABOR AND MATERIALS

Copper	}	Connection			\$
Lead					
Curb	}	Cock Valve T. S. & V.			
			in.		
Service Box	}	Short 3½x4½ Long 4½x5½ Buff or Rdway			
Old returned					
Ft.	}	Copper Galv Iron Cast Iron	Pipe at		
in.					
Nipples		in. at			
Bushings		to in. at			
Red'g Inc'g	}	Couplings	to in. at		
Union		in. at			
Meter		in. at			
Lead Joints		at			
Leadite Joints		at			
Hrs. Foreman		at			
Hrs. Chauffeur		at			
Hrs. Tapper		at			
Hrs. Labor		at			
Hrs. Labor		at			
Hrs. Compressor		at			
Compensation Ins.					
Trucking					
Builders Use of Water					


St. 65W
 Pl.
 Ave. No. 69

Notre Dame

Name of Owner

Tax ID # 302.19-25-20

Labor and Mat'l. Report AUG 25 1939 19

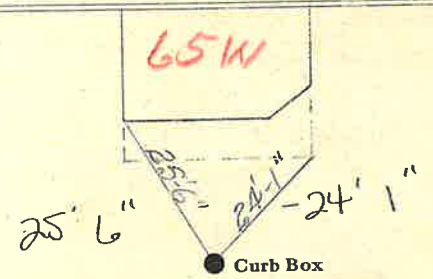

	Elev. of
Main	Main at tap
Gate at ●	● Gate at

● Curb Box