


LABOR AND MATERIALS

1	Copper	} Connection	3/4"	\$
	Lead			
1	Curb	} Cock Valve F.S. & V:	3/4 in.	\$
1	Service box	} Short 3 1/2 x 4 1/2 Long 4 1/2 x 5 1/2 Buff or Rdway.		\$
	Old returned			
30	3/4 in.	} Copper G.I. G.I.	} Pipe at	\$
	Nipples	in. at	\$	
	Bushings	to in. at	\$	
	Red'g } Inc'g }	Coupl'gs. to in. at	\$	
	Union	in. at	\$	
	Meter	in. at	\$	
	Lead Joints at		\$	
	Compound Joints at		\$	
	Maintenance Foreman		\$	
	Hrs. Water Maint. Man-1 at		\$	
	Hrs. Water Maint. Man-2 at		\$	
	Hrs. Garage Foreman at		\$	
	Hrs. Labor at		\$	
	Hrs. Compressor at		\$	
	Compensation Ins. at \$	per C	\$	
	Trucking		\$	
	Pay't Patch		\$	
	Tap by Gifford & Co.		\$	
	9-17-57		\$	
	O'head		\$	

West
Notre Dame St.
Ave. No. 66

Name of Owner
Edward Buckley

Labor and Mat'l. Report Sept 17 19 57

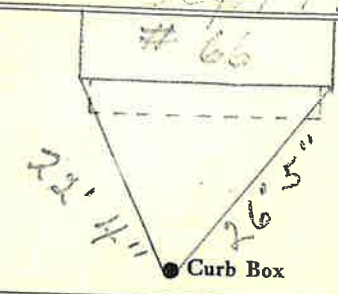

6" Main Elev. of Main at tap 7'

Gate at • Gate at
Tax ID # 302.19-28-11

Tax ID # • Curb Box
old Tap
disconnected
at main