

LABOR AND MATERIALS


1	Copper Lead	Connection	3/4		\$	1.78
1	Curb	Clock Valve T. S. & V.	3/4	in.	\$	2.61
1	Service box Old returned	Short 3 3/4 X 4 1/2 Long 4 1/2 X 5 1/2 Buff or Rdway			\$	1.80
29	Ft.	3/4	in.	Copper Galv. Iron Cast Iron	Pipe at	23 6.67
	Nipples	in. at			\$	
	Bushings	to		in. at	\$	
	Red'g Inc'g	Couplings		to		in. at \$
	Union	in. at			\$	
	Meter	in. at			\$	
	Lead Joints at				\$	
	Compound Joints at				\$	
1	Hrs. Foreman at	WWM	84		\$	84
14	Hrs. Chauffeur at		75		\$	10.50
5	Hrs. Tapper at				\$	3.75
14	Hrs. Labor at		65		\$	9.10
	Hrs. Labor at				\$	
2	Hrs. Compressor at		8 1/2		\$	1.75
	Compensation Ins.				\$	67
	Trucking				\$	1.00
	Builders Use of Water	2 Pitch			\$	9.00
	Tip by WMS				\$	
					\$	
					\$	
					\$	49.49

11-146

St. <sup>70 West</sup>  
Pl. \_\_\_\_\_  
Ave. No. <sup>72</sup>

Name of Owner  
Simmone

Labor and Mat'l. Report <sup>Apr 3</sup> 1946

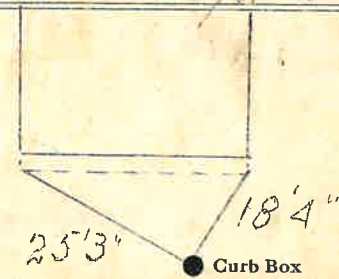

6 Main  
Elev. of Main at tap <sup>5</sup>

Gate at ● Gate at ●

● Curb Box  
Tax 10# 302.19-28-13

LSM-5C-6-1-45