


Labor and Materials

1	Copper	Lead	Connection	3/4"	\$	3.20
1	Curb	Cock Valve	T.S. & V.	3/4" in.	\$	1.00
1	Service Box	Short	3/4" x 4 1/2"		\$	1.30
	Old returned	Long	1 1/2" x 5 1/2"	Buff. or Redway	\$	
2.0	Ft.	3/4"	Copper Galv. Iron	Pipe at	\$	4.40
			Cast Iron		\$	
	Nipples		in. at	\$		
	Bushings		to in. at	\$		
	Red'g Inc'g	Couplings	to in. at	\$		
	Union		in. at	\$		
	Meter		in. at	\$		
	Lbs. Br. Stone	at		\$		
	Lbs. Sand	at		\$		
	Bags Cement	at		\$		
	Paving Brick	Mack Red Asphalt	at	\$		
	Lead Joints	at		\$		
	Leadite Joints	at		\$		
9	Hrs. Foreman	at		\$	4.63	
13	Hrs. Common Labor	at		\$	4.28	
	Hrs. Common Labor	at		\$		
	Hrs. Mason	at		\$		
	Hrs. Mason's Helper	at		\$		
2	Hrs. Compressor	at		\$	3.00	
	Compensation Ins			\$	2.9	
	Trucking			\$	1.00	
	Builders' Use of Water			\$		
Total					\$	25.10

28-91 12-14 E
 Labor and Material Report Aug 1 1928

3/4" Tap at 7. Centre Dome at

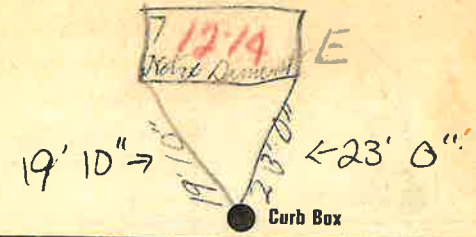

6' Main Elev of Main at tap 4 1/2
 Gate at ● Gate at ●

● Curb Box

Old tap shut off

#12
 Tax 10# 302.20-12-18