

LABOR AND MATERIALS


1 Copper } Connection 3/4" \$ \_\_\_\_\_  
~~Lead~~ }  
 1 Curb } Cock } 3/4 in. ORISEAL \$ \_\_\_\_\_  
 } Valve }  
 } T.S. & V. }  
 1 Service box { Short 3 1/2 x 4 1/2 }  
 Old returned { Long 4 1/2 x 5 1/2 } \$ \_\_\_\_\_  
 { Buff or Rdway }  
 31 Ft. in. { Copper } Pipe at \$ \_\_\_\_\_  
 { C.I. }  
 { C.I. }  
 Nipples in. at \$ \_\_\_\_\_  
 Bushings to in. at \$ \_\_\_\_\_  
 Red'g }  
 Inc'g } Coupl'gs to in. at \$ \_\_\_\_\_  
 Union in. at \$ \_\_\_\_\_  
 Meter in. at \$ \_\_\_\_\_  
 Lead Joints at \$ \_\_\_\_\_  
 Compound Joints at \$ \_\_\_\_\_  
 Maintenance Foreman \$ \_\_\_\_\_  
 Hrs. Water Maint. Man-1 at \$ \_\_\_\_\_  
 Hrs. Water Maint. Man-2 at \$ \_\_\_\_\_  
 Hrs. Garage Foreman at \$ \_\_\_\_\_  
 Hrs. Labor at \$ \_\_\_\_\_  
 Hrs. Compressor at \$ \_\_\_\_\_  
 Compensation Ins. at \$ \_\_\_\_\_ per C \$ \_\_\_\_\_  
 Trucking \$ \_\_\_\_\_  
 Pav't Patch \$ \_\_\_\_\_  
 \$ \_\_\_\_\_  
 \$ \_\_\_\_\_  
 \$ \_\_\_\_\_  
 O'head \$ \_\_\_\_\_

TAP MADE BY SEYMOUR & CO  
8/31/1971

St. ~~St.~~ Ave. No. 72  
W. NOTRE DAME

Name of Owner  
Phillip Potter

Labor and Mat'l. Report 8-31 1971

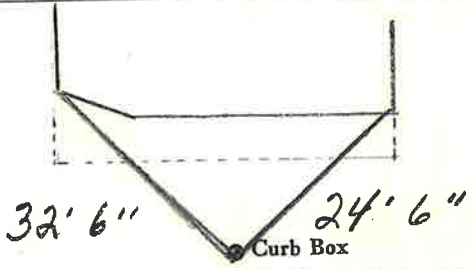

6" Main Elev. of Main at tap 5'  
 Gate at • Gate at

• Curb Box

TAX ID # 302.19-28-14